

NZPO

DRAWN: P.B.2
CHECKED: [Signature]
WIRING: [Signature]
CIRCUIT: [Signature]


ISSUE: 1
DATE: [Blank]
APP: [Blank]

REF: 663-2-11
SIZE: F
50Y H

AMENDMENT PARTICULARS

U10 - INT RING TONE WAS RING TONE (47514)
WIRING OF 5S RELAY MOD. RESIS. YD & YE WERE NOT SHN.
JUMPING TO ANS. JACKS MODIFIED.

SLEEVE CONTROL SYSTEM
TRUNK SUBSCRIBER C.B.
WITH BALLAST RESISTANCE
2000 TYPE

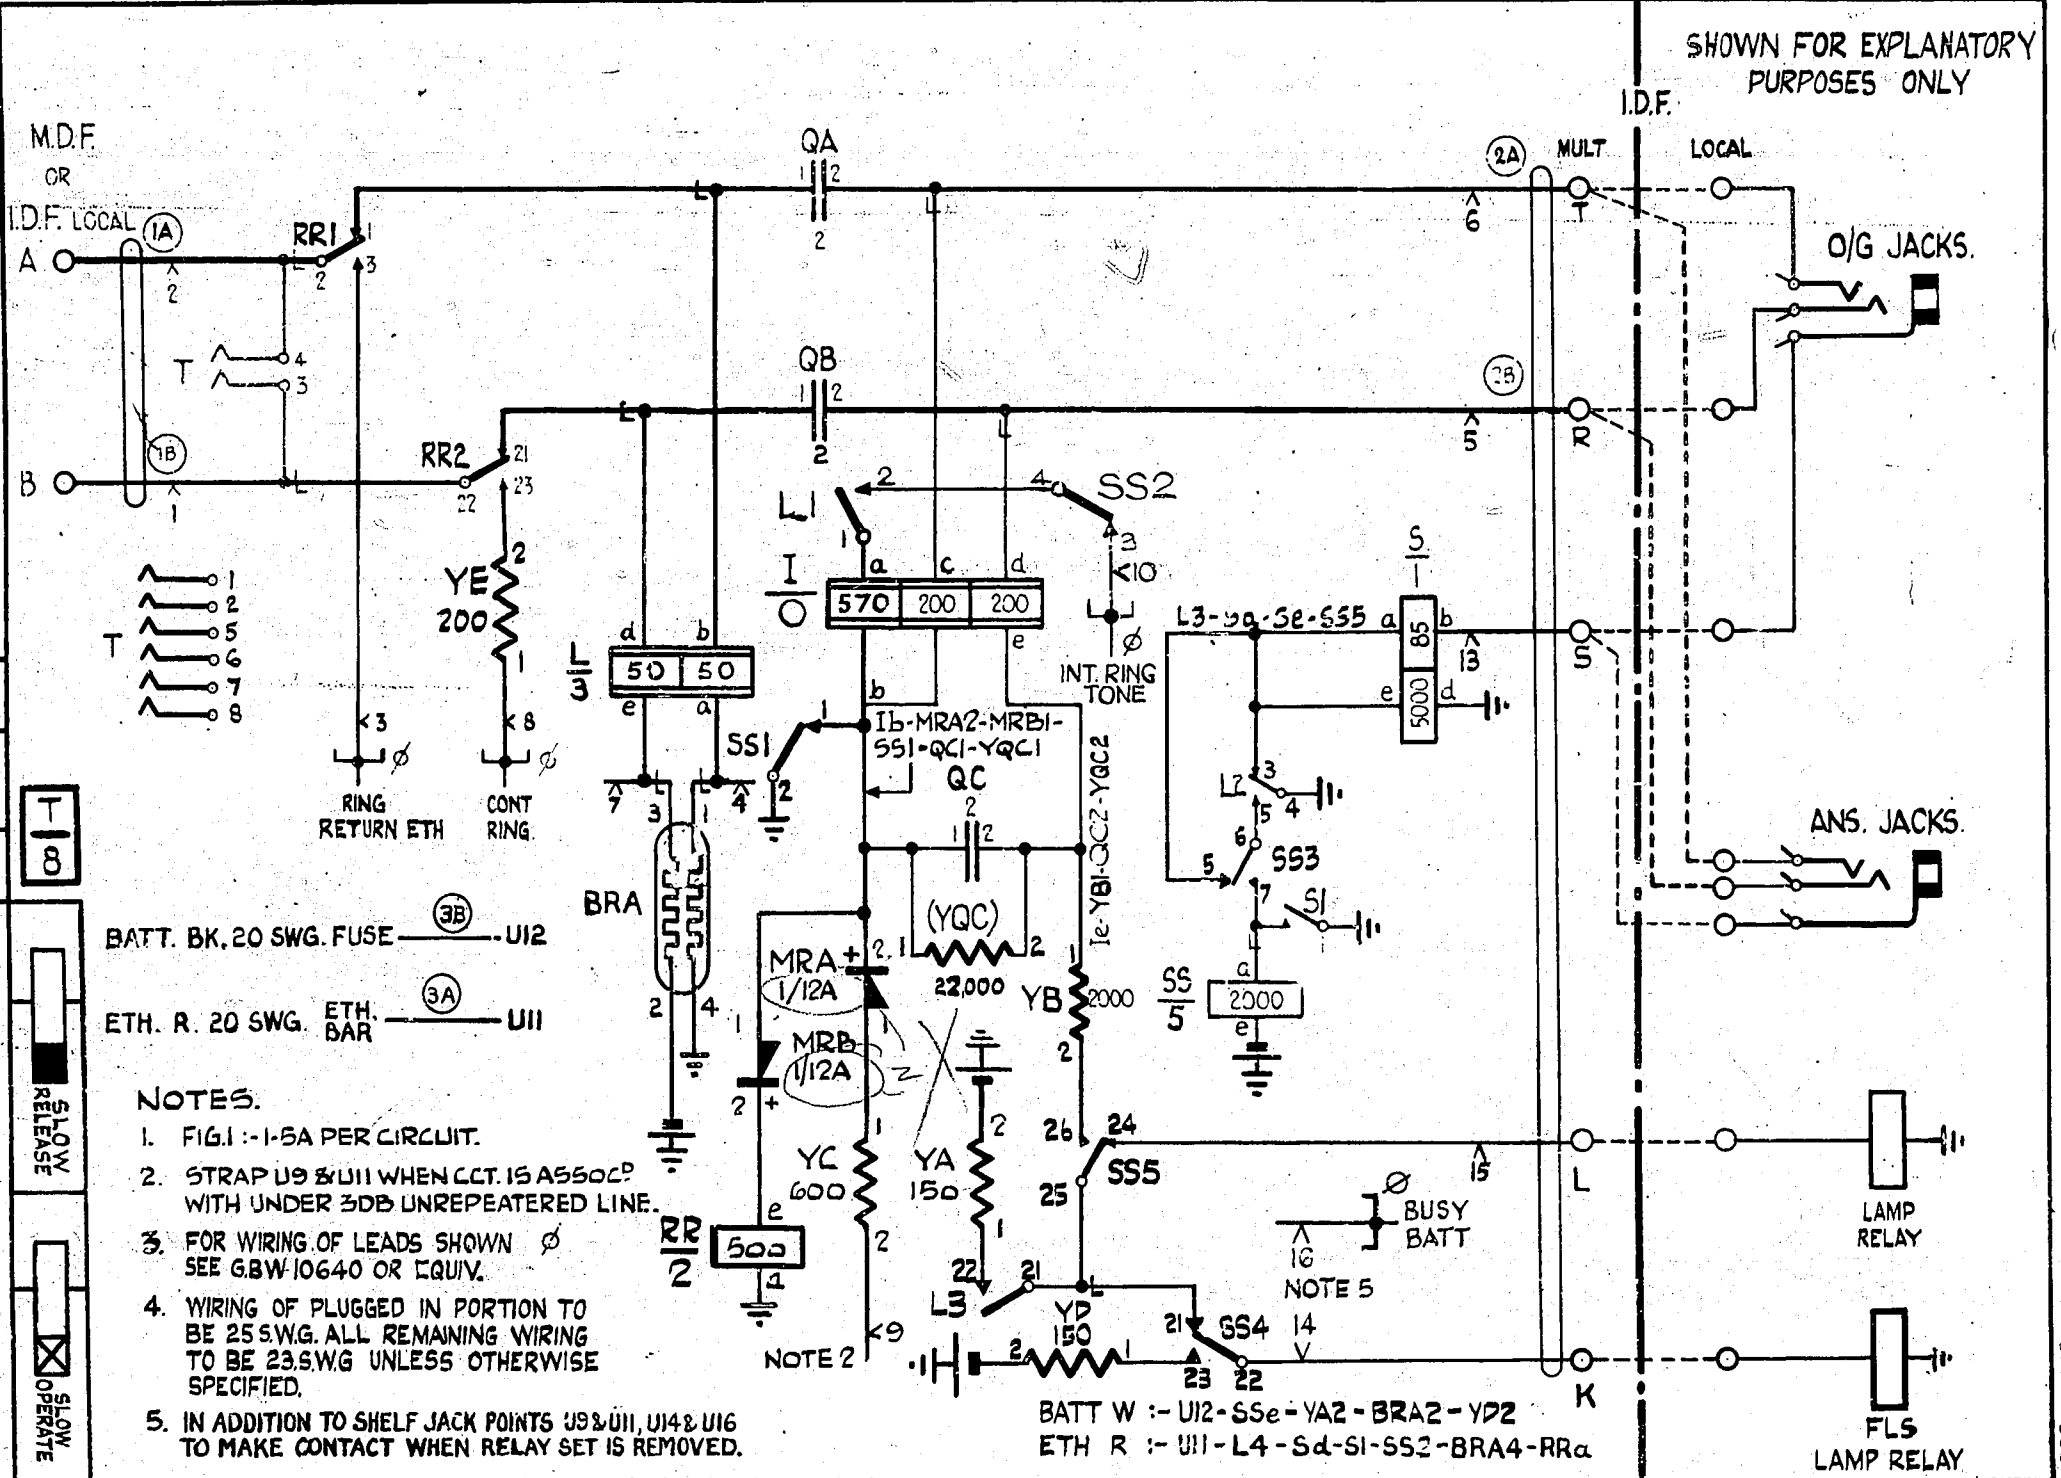

- NOTES:
- FIG. 1 :- 1-5A PER CIRCUIT.
 - STRAP U9 & U11 WHEN C.C.T. IS ASSOC'D WITH UNDER 3DB UNREPEATERED LINE.
 - FOR WIRING OF LEADS SHOWN SEE G.B.W. 10640 OR EQUIV.
 - WIRING OF PLUGGED IN PORTION TO BE 25 S.W.G. ALL REMAINING WIRING TO BE 23 S.W.G. UNLESS OTHERWISE SPECIFIED.
 - IN ADDITION TO SHELF JACK POINTS U9 & U11, U14 & U16 TO MAKE CONTACT WHEN RELAY SET IS REMOVED.